


- NOTES :**
1. FEATURE LOCATIONS ARE APPROXIMATE.
  2. PREVIOUS OBSERVATIONS SHOWN IN BLACK
  3. PREVIOUS CRACK PATTERN WAS COVERED BY NEW (2004) ASPHALT PATCH
  4. **MAY 11, 2015 OBSERVATIONS ARE SHOWN IN RED**
- ① PHOTOGRAPH NUMBER, AND APPROXIMATE DIRECTION AND LOCATION

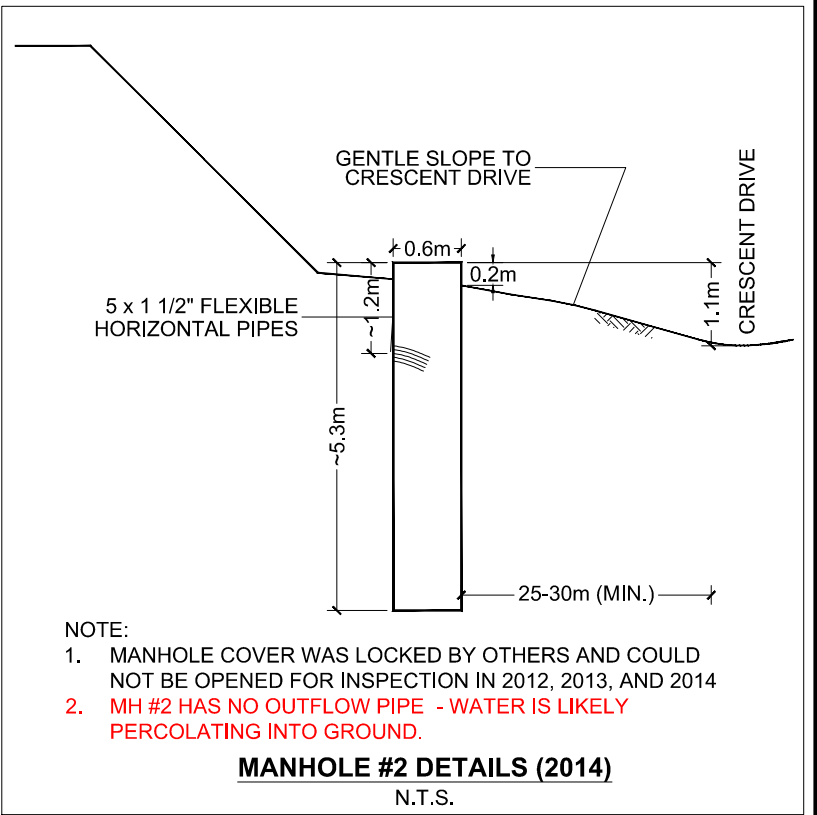

- NOTE:**
1. MANHOLE COVER WAS LOCKED BY OTHERS AND COULD NOT BE OPENED FOR INSPECTION IN 2012, 2013, AND 2014
  2. **MH #2 HAS NO OUTFLOW PIPE - WATER IS LIKELY PERCOLATING INTO GROUND.**

**MANHOLE #2 DETAILS (2014)**  
N.T.S.

**LEGEND**  
SI - SLOPE INCLINOMETER  
SP - STANDPIPE PIEZOMETER

MANHOLE NUMBER	GPS COORDINATES (UTM-NAD83)	
	NORTHING	EASTING
MH #1	6023351	644914
MH #2	6023367	644730
METAL COVER	6023374	644771

**NORTH CENTRAL REGION (ATHABASCA AREA)  
- 2015 GEOHAZARD ASSESSMENT**

**NC14: HWY 661: 02 FORT ASSINIBOINE (km 1.8)  
SITE PLAN SHOWING MID-HILL SLIDE AREA**

**FIGURE NC14-2**

DRAWN BY	ML
DESIGNED BY	TSA
APPROVED BY	DWP
SCALE	N. T. S.
DATE	SEPTEMBER 2015
FILE No.	15-16-359