

**STONY PLAIN REGION
GEOHAZARD RISK ASSESSMENT
SITE INSPECTION FORM**

SITE NUMBER AND NAME: NC 22 - Pavement Dip	HIGHWAY AND KM: Hwy 759:02, km 1.42	PREVIOUS INSPECTION DATE: May 20, 2010	INSPECTION DATE: June 14, 2011
LEGAL DESCRIPTION: NW 11-49-6-W5M	NAD 83 COORDINATES: -51362 E, 5898567 N	RISK ASSESSMENT: PF: 9 CF: 2 TOTAL: 18	

SUMMARY OF SITE INSTRUMENTATION: Survey pins	INSPECTED BY: Adam Gmeinwieser, P. Eng. (EBA) Chris Gräpel, P. Eng. (EBA) Sabhago Oad, P. Eng. (TRANS) Fred Cheng, P. Eng. (TRANS)
--	---

LAST READING DATE:
PRIMARY SITE ISSUE: Section of asphalt with as much as 0.6 m settlement
APPROXIMATE DIMENSIONS: 30 m in length
DATE OF REMEDIAL ACTION:

ITEM	CONDITION EXISTS		DESCRIPTION AND LOCATION	NOTICABLE CHANGE FROM LAST INSPECTION	
	YES	NO		YES	NO
Pavement Distress	X		30 m long strip of asphalt; 0.6 m maximum settlement		X
Slope Movement		X			
Erosion		X			
Seepage		X			
Culvert Distress	X		Culvert south of pavement dip; blocked with static water		X

COMMENTS:
 Location and site plan shown on Figure NC-22.
 Site conditions shown in Photos 1 and 2.
 Risk level unchanged from 2010.
 Foam columns installed in Spring 2010 – performing well so far.
 Asphalt pavement placed after foam injection in Spring 2010.
 Survey pins installed in new asphalt to monitor settlement.

**STONY PLAIN REGION
GEOHAZARD RISK ASSESSMENT
SITE INSPECTION FORM**

SITE OBSERVATIONS:

- Length of pavement dip area is approximately 30 m long and appears to be relatively uniform across the width of the pavement;
- Pavement dip appeared to be about 0.6 m before foam injection implemented;
- Embankment is about 3 m high with approximately 3H:1V sideslopes outside of the dip;
- Sideslopes within dip area are concave and steep (about 1H:1V);
- New asphalt pavement placed in summer 2010. Cracks beginning to reflect through new pavement;
- 800 mm diameter culvert located south of the pavement dip. Culvert appears to be blocked and standing water is located within the ditch on both sides of the highway;
- Small sinkhole observed about 3 m east of the west outlet of the culvert. Relatively unchanged from 2008 inspection;
- Deflection of barbed wire fence observed at toe of east embankment (i.e. northbound lane); and
- Lateral spreading of embankment suspected due to concave shape of sideslopes in dip area and deflection of the barbed wire fence.

RECOMMENDATIONS:


- Continue to monitor survey pins installed as part of the foam injection study.
- MCI should replace the existing culvert and develop a construction plan for improvement of both ditches.
- TRANS operations staff and EBA to discuss milling pavement versus levelling asphalt with pavement options.




Photo 1: Asphalt overlay placed after foam injection




Photo 2: Repaired pavement dip facing northeast

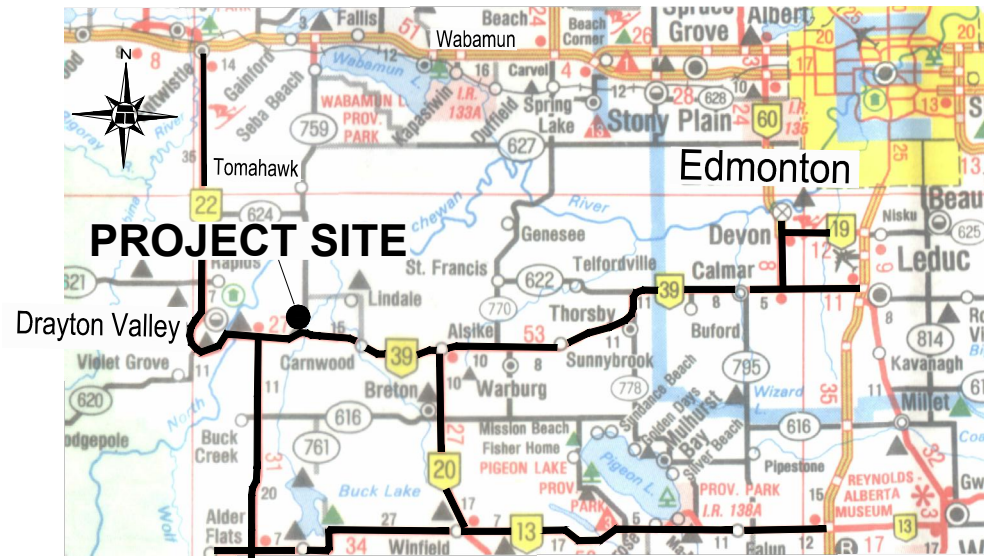

KEY PLAN
N.T.S

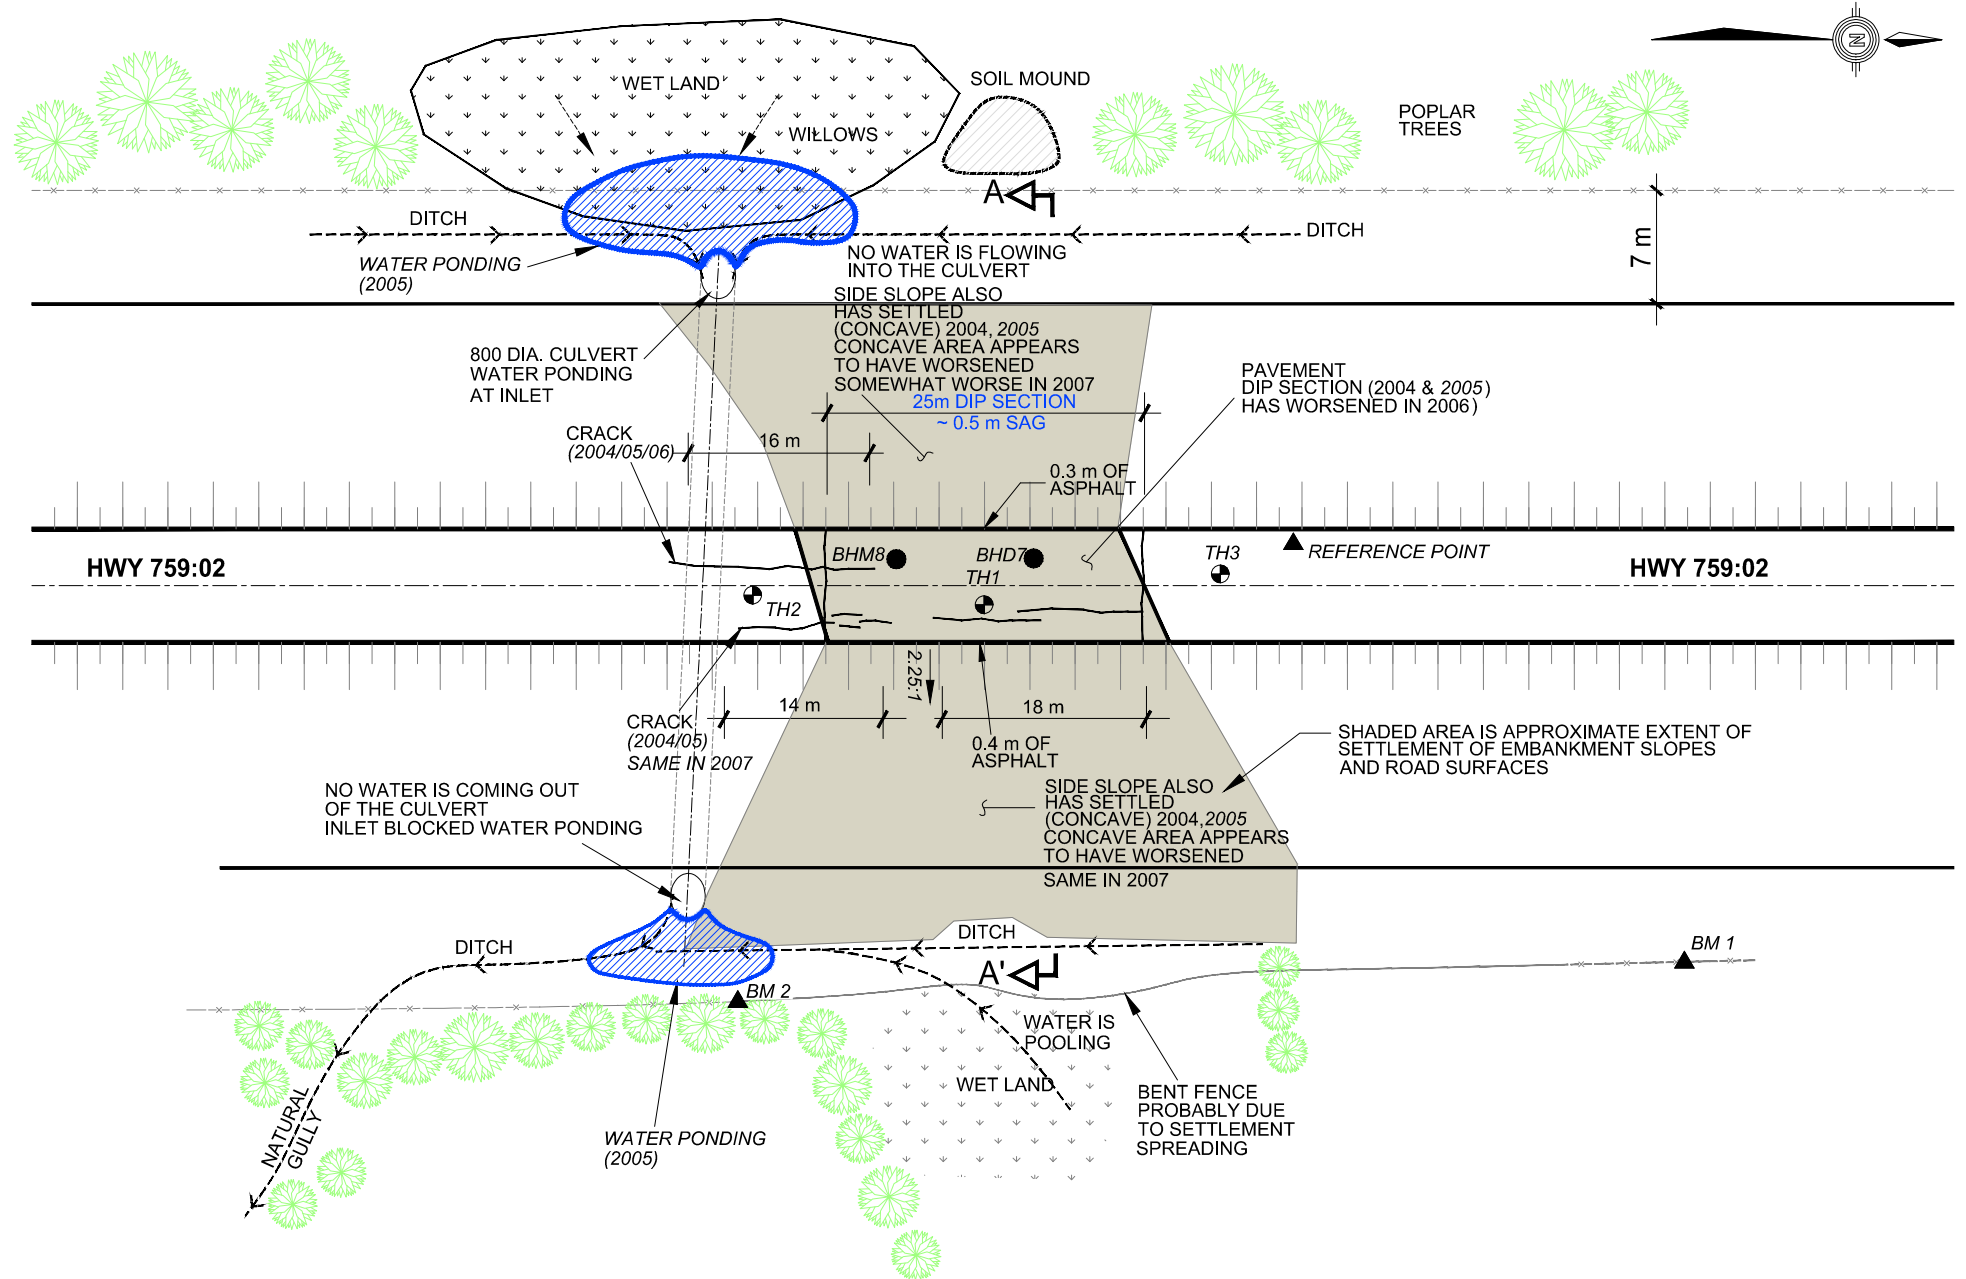

SITE PLAN
NOT TO SCALE

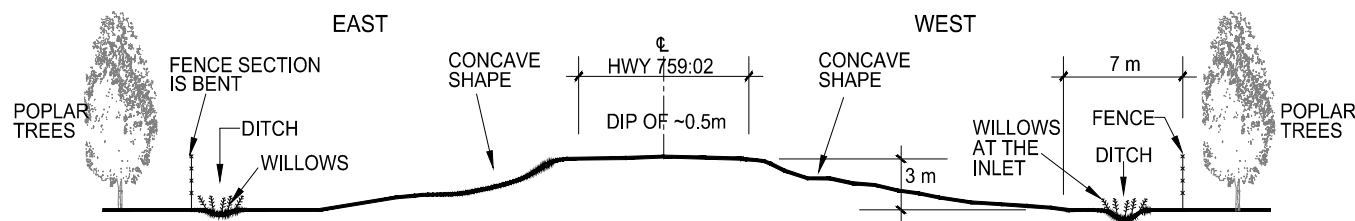

SECTION A-A'
(NOT TO SCALE)

BASE DRAWING PROVIDED BY THURBER ENGINEERING LTD.

LEGEND :

- BOREHOLE DRILLED BY JACQUES WHITFORD (2006)
- BOREHOLE DRILLED BY EBA (2010)
- ▲ BENCH MARK
- CONCAVE SIDE SLOPES

NOTES :

1. FEATURE LOCATIONS ARE APPROXIMATE.
2. SITE INSPECTION CARRIED OUT IN MAY, 2004
3. MAY 2007 OBSERVATIONS SHOWN IN RED
4. BM1 - RELATIVE ELEVATION 99.42 m
5. BM2 - RELATIVE ELEVATION 96.282 m
4. REFERENCE POINT - RELATIVE ELEVATION 100.0 m

CLIENT
Government of Alberta
Transportation





NC 22 PAVEMENT DIP - FOAM TREATMENT PLAN
HWY 759:02, KM 1.5


NC 22 PAVEMENT DIP SITE PLAN

PROJECT NO. E12101085.003	DWN TK	CKD RJM	REV 0
OFFICE EDM	DATE November 18, 2011		

Figure 1

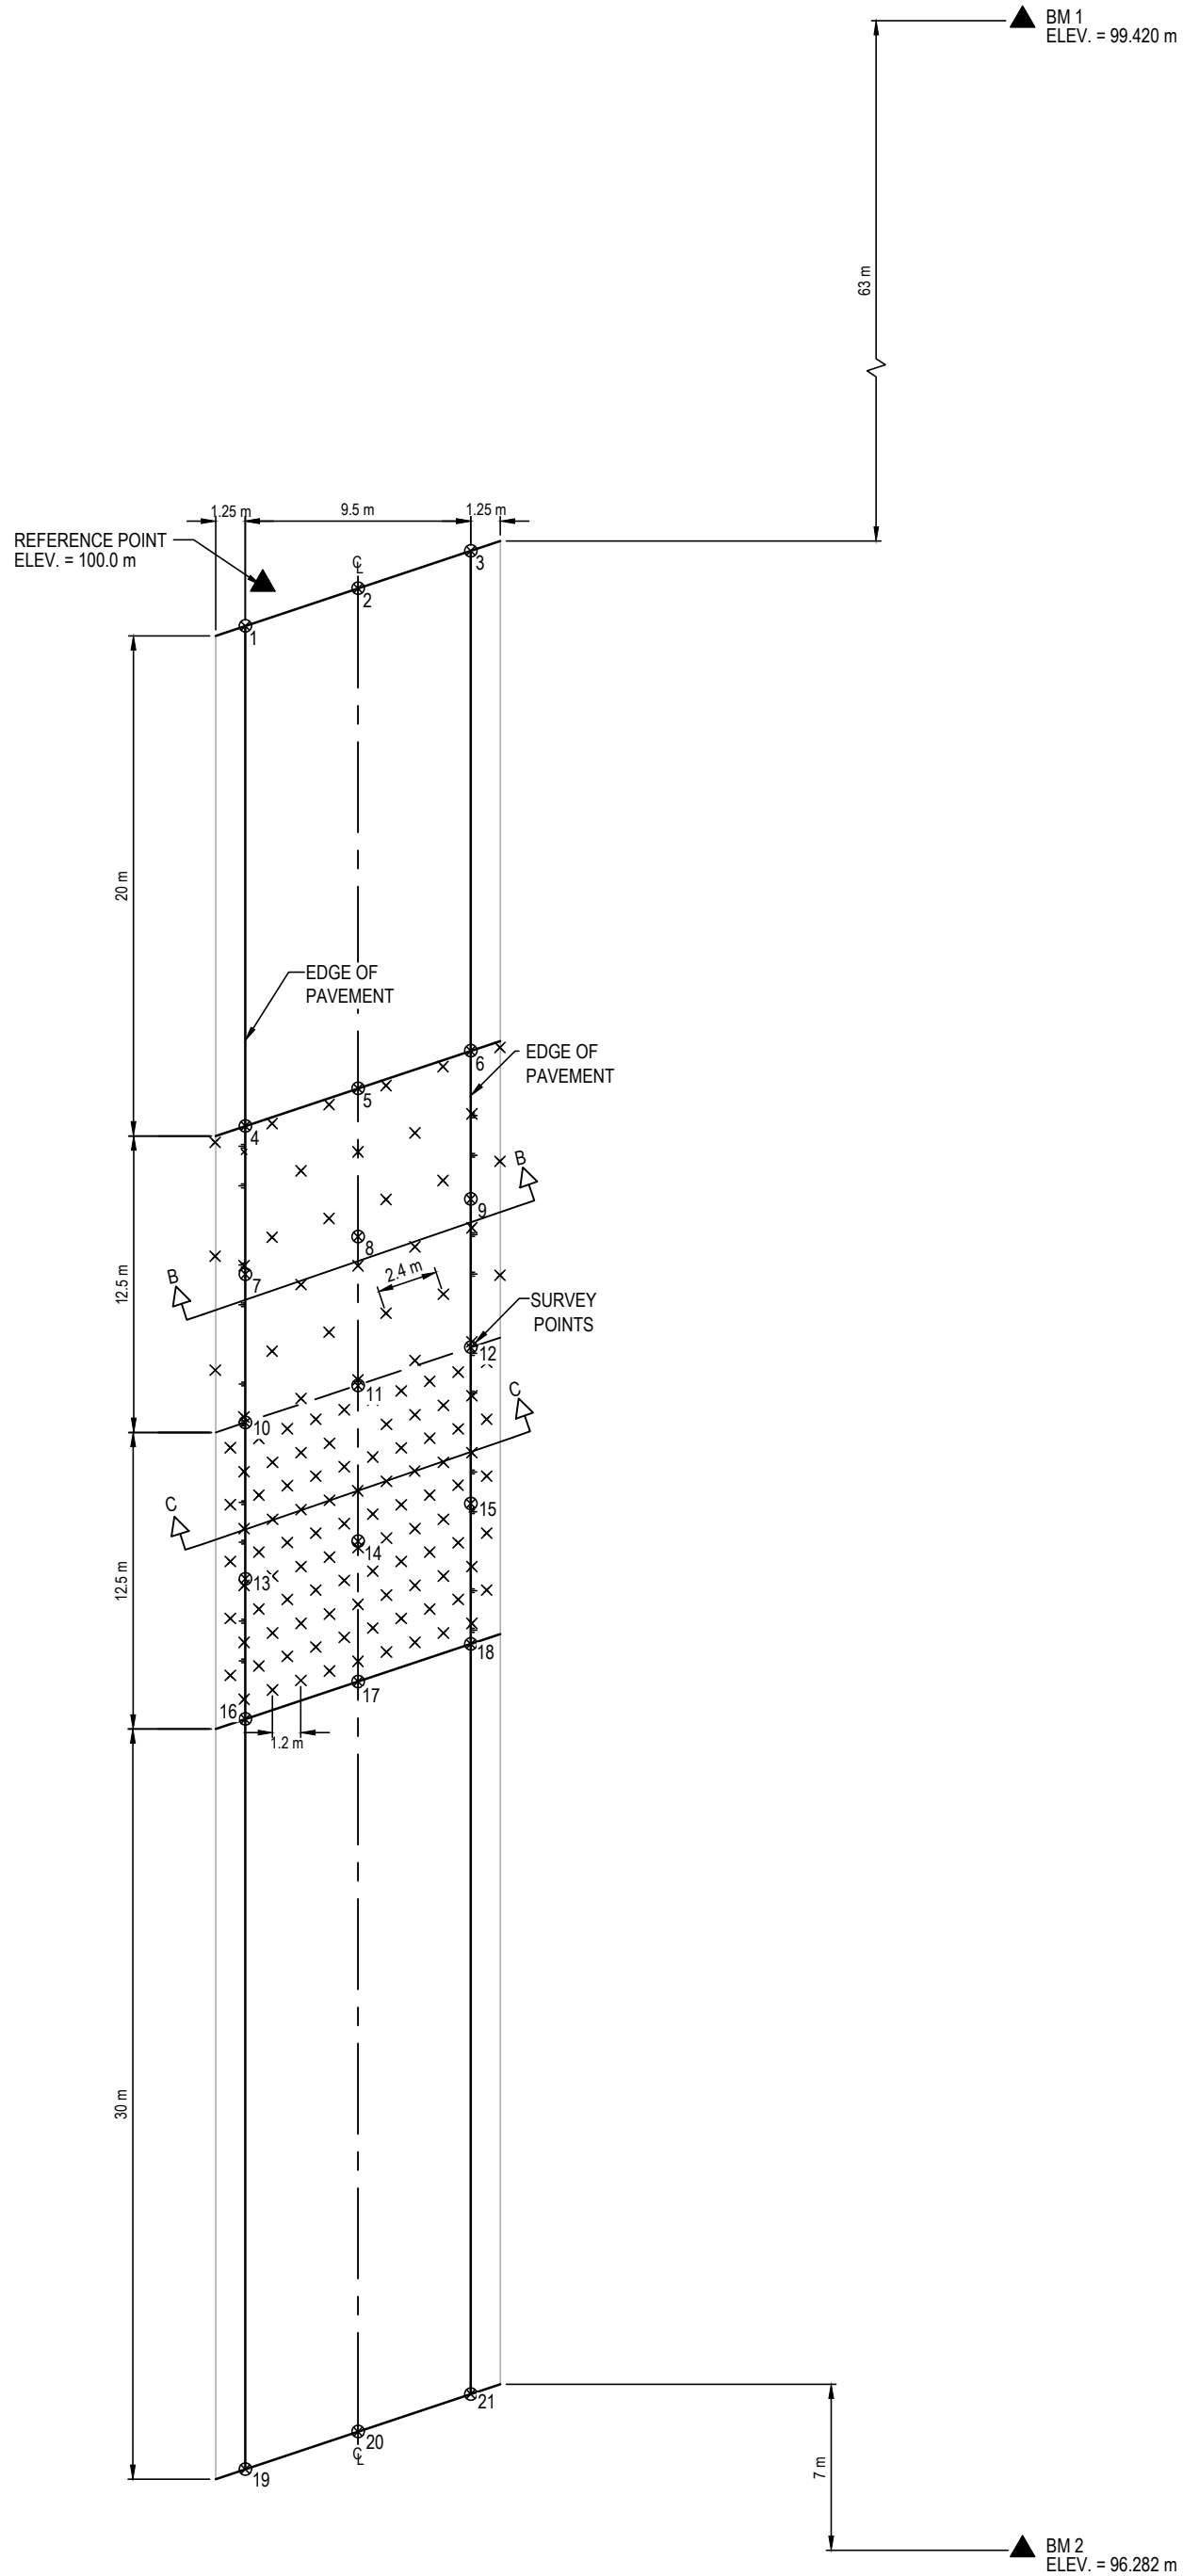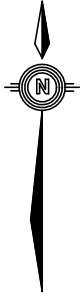

LEGEND:
 ⊗ - SURVEY POINTS
 × - INJECTION POINTS

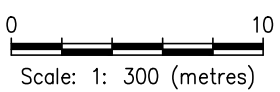

CLIENT
Government of Alberta
Transportation



NC 22 PAVEMENT DIP - FOAM TREATMENT PLAN
HWY 759:02, KM 1.5

E12101085 NORTH CENTRAL (STONY PLAIN)
GEOHAZARD RISK MANAGEMENT PROGRAM
NC 22 FOAM INJECTION TREATMENT PLAN

PROJECT NO. E12101085.003	DWN TK	CKD RJM	REV 0
OFFICE EDM	DATE November 18, 2011		

Figure 2



Photo 1: Asphalt overlay placed after foam injection



Photo 2: Repaired pavement dip facing northeast