



H:\13000\13351 Geohazard Assessment - Peace River\High Level (CON0017602)\Drafting\2019\BDM\13351 PH077-1-1&-2.dwg - OVERALL - Nov. 18, 2019

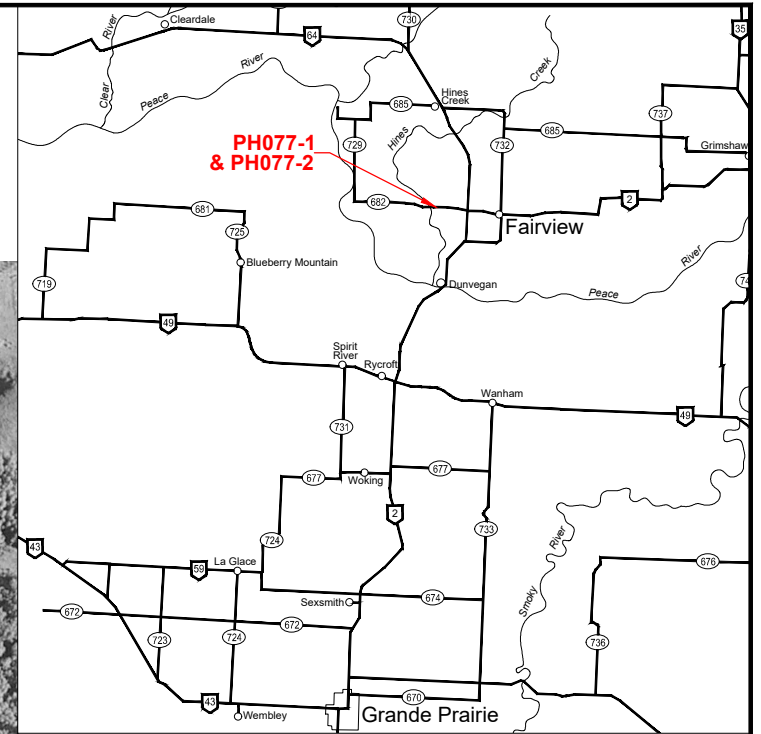

KEY PLAN
SCALE 1:1 500 000


BASE AIRPHOTO TAKEN IN JULY 2, 2006 TO AUGUST 10, 2006

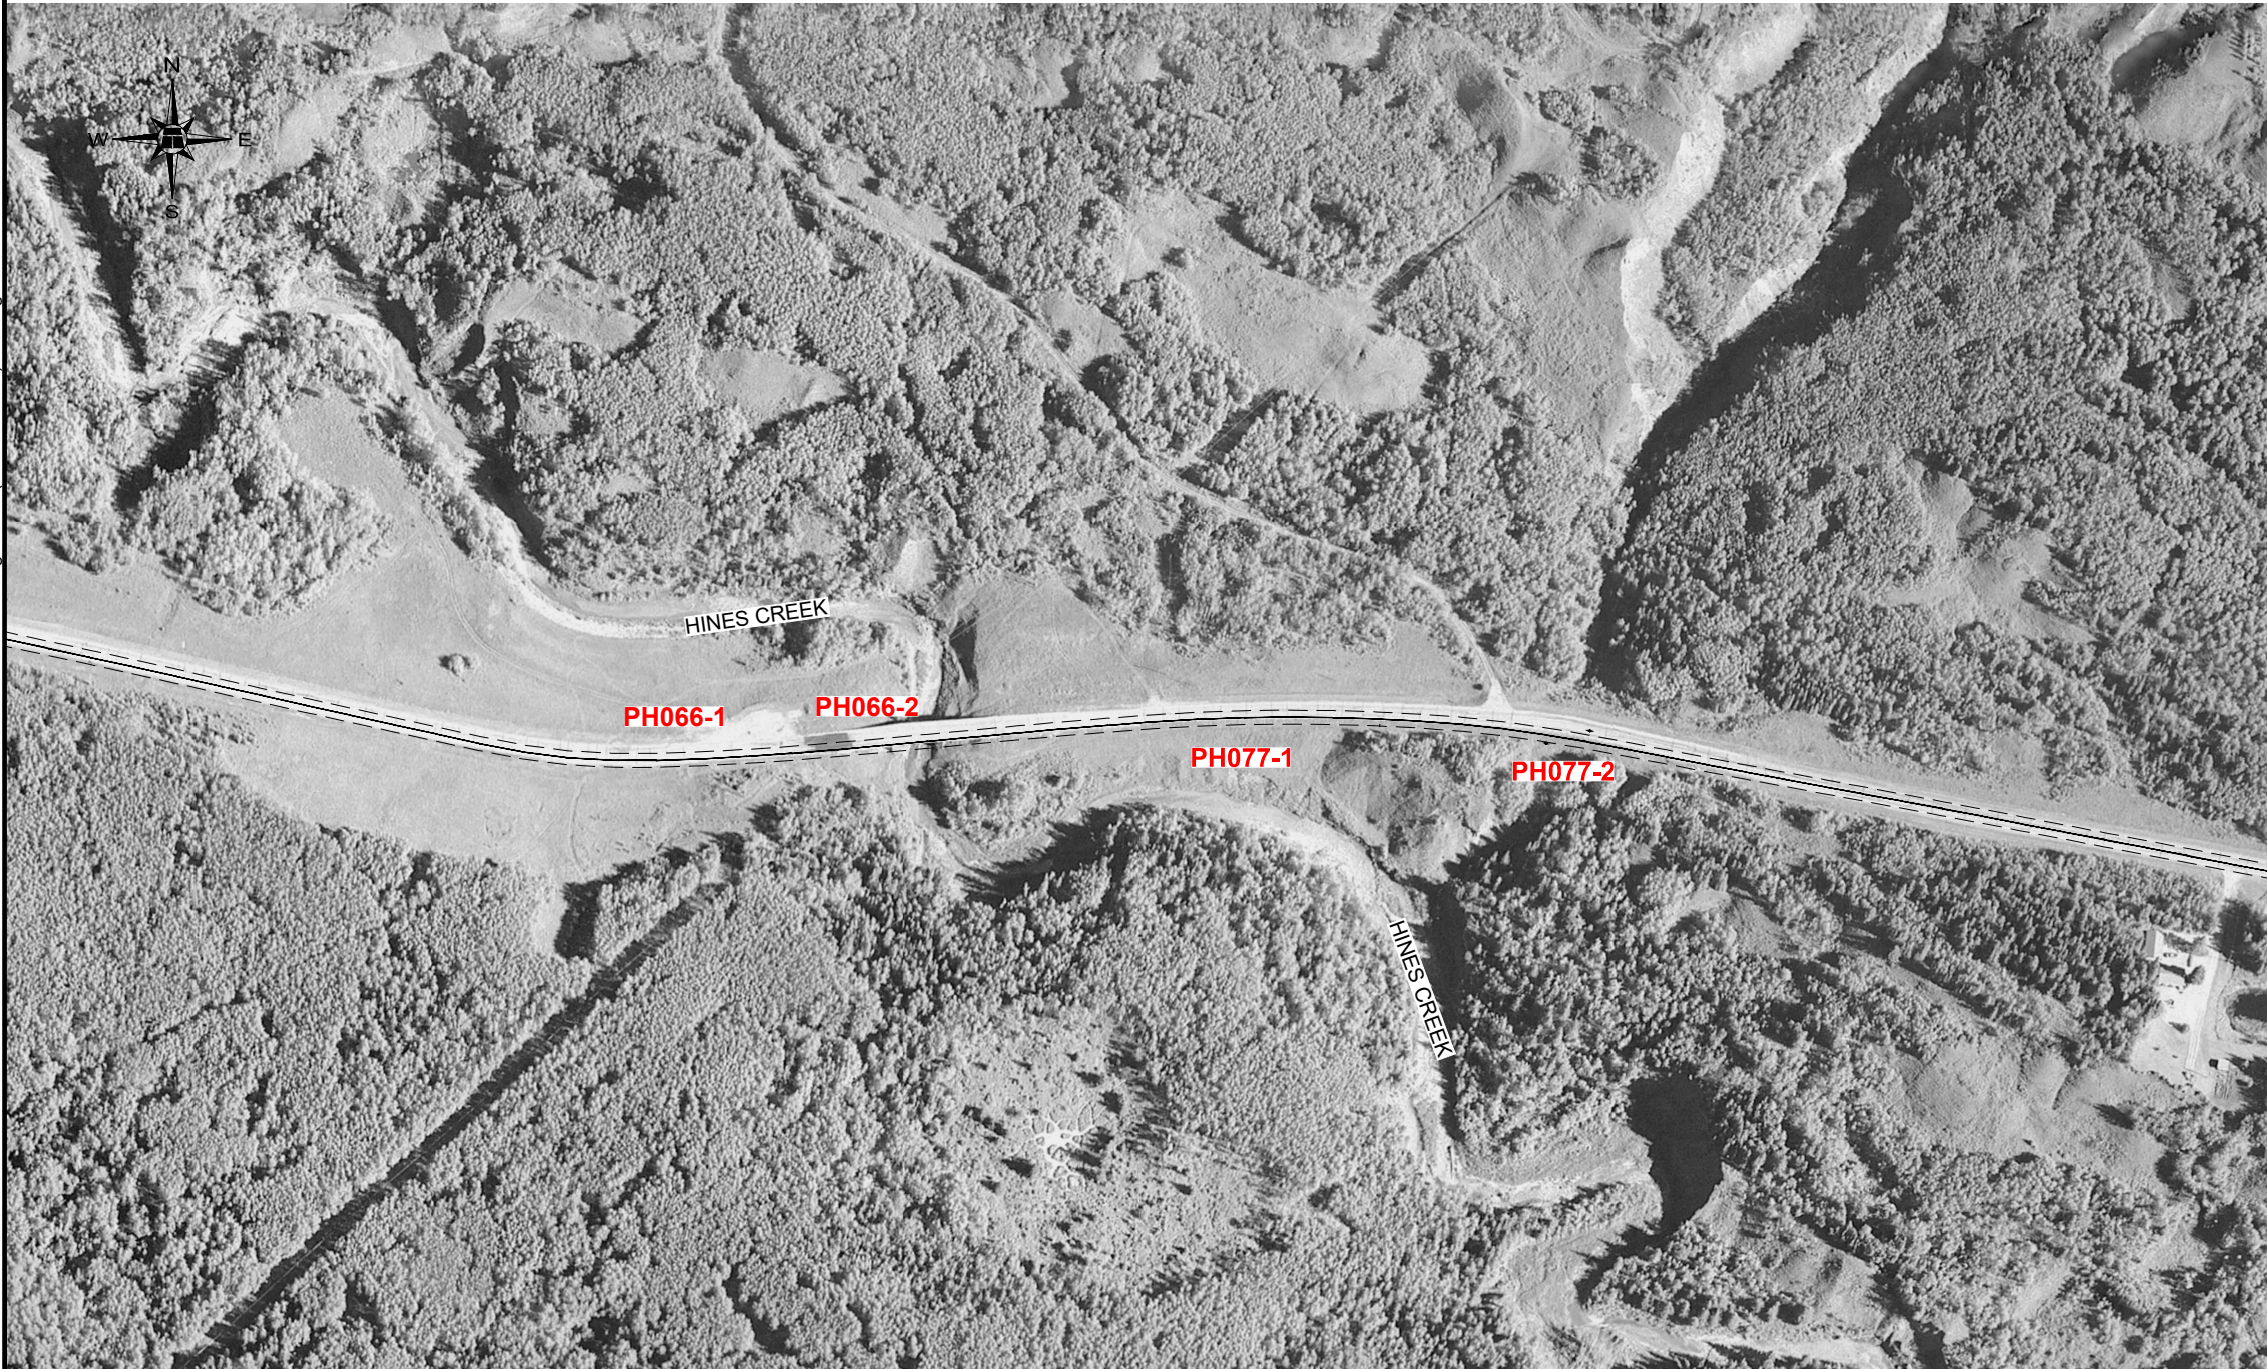

**PEACE REGION (PEACE RIVER/HIGH LEVEL)
PH077-1 & PH077-2 EAST SIDE OF HINES CREEK BRIDGE
HWY 682:02, km 12.6~12.7**

SITE LOCATION PLAN


DWG No. 13351-PH077

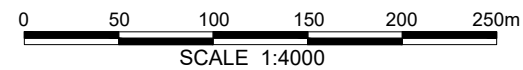

DRAWN BY	ML
DESIGNED BY	BDM
APPROVED BY	DWP
SCALE	1:4000
DATE	MAY 13, 2019
FILE No.	13351



H:\13000\13351 Geohazard Assessment - Peace RiverHigh Level (CON00176602)\Drafting\2019\BDM\13351 PH077-1-1 & -2.dwg - PH077-1-1 - Nov. 18, 2019

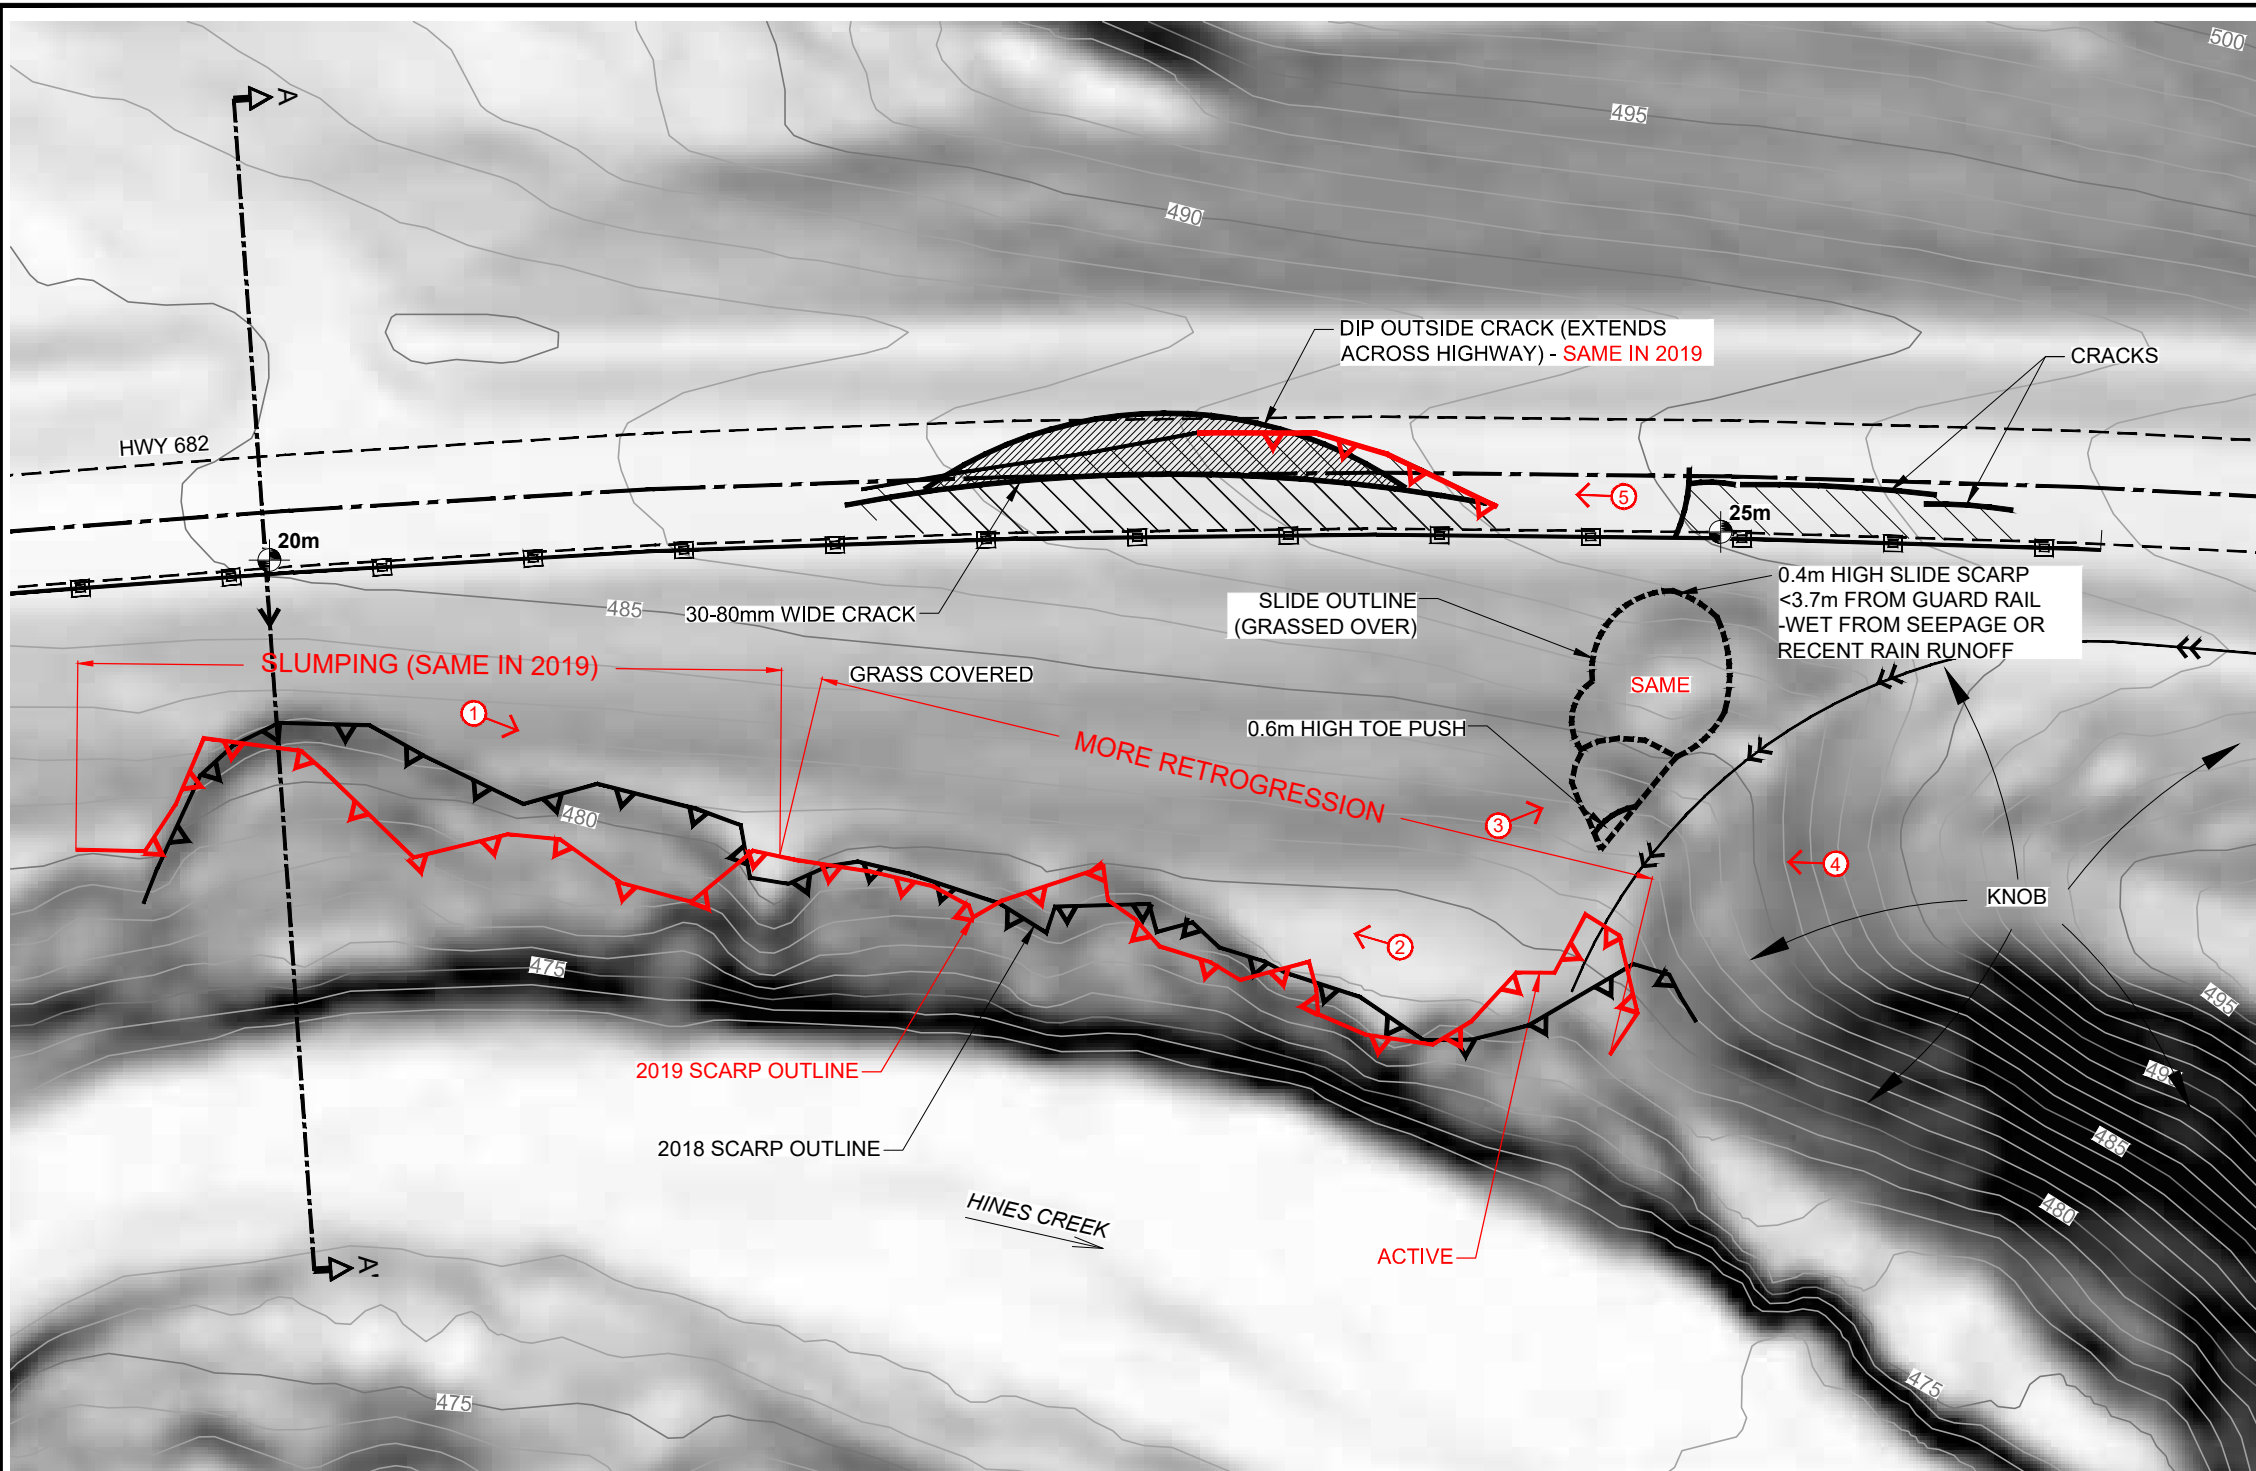

- LEGEND**
- APPROXIMATE GUARD RAIL LOCATION
 - DITCH
 - DIRECTION AND NUMBER OF PHOTO
 - SLIDE SCARP
 - PROPOSED SI / PIEZOMETER LOCATION
 - 25m DEPTH OF THE TEST HOLE IN METRES

- NOTES**
1. MAY 13, 2019 OBSERVATIONS SHOWN IN RED.
 2. LOCATIONS ESTIMATED WITH HANDHELD GPS.
- 0 5 10 15 20 25 30m
SCALE 1:500

BASE LIDAR FLOWN IN 2015




PEACE REGION (PEACE RIVER/HIGH LEVEL)



PH077-1: EAST SIDE OF HINES CREEK BRIDGE
HWY 682:02, km 12.6~12.7
2019 INSPECTION PLAN - SITE 1

DWG No. 13351-PH077-1-1

DRAWN BY	ML
DESIGNED BY	BDM
APPROVED BY	DWP
SCALE	1:500
DATE	MAY 13, 2019
FILE No.	13351

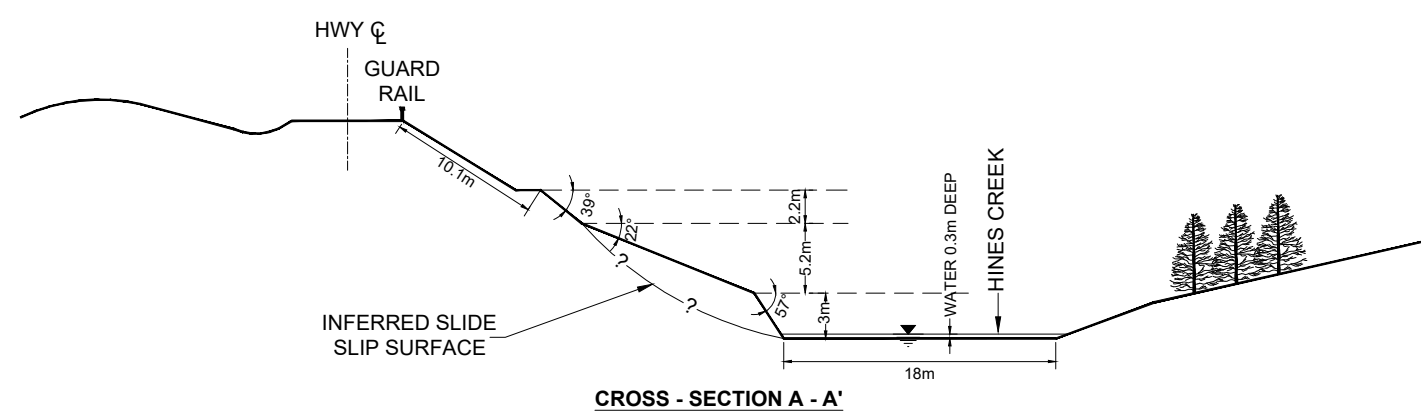

CROSS - SECTION A - A'

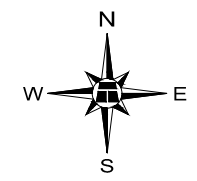
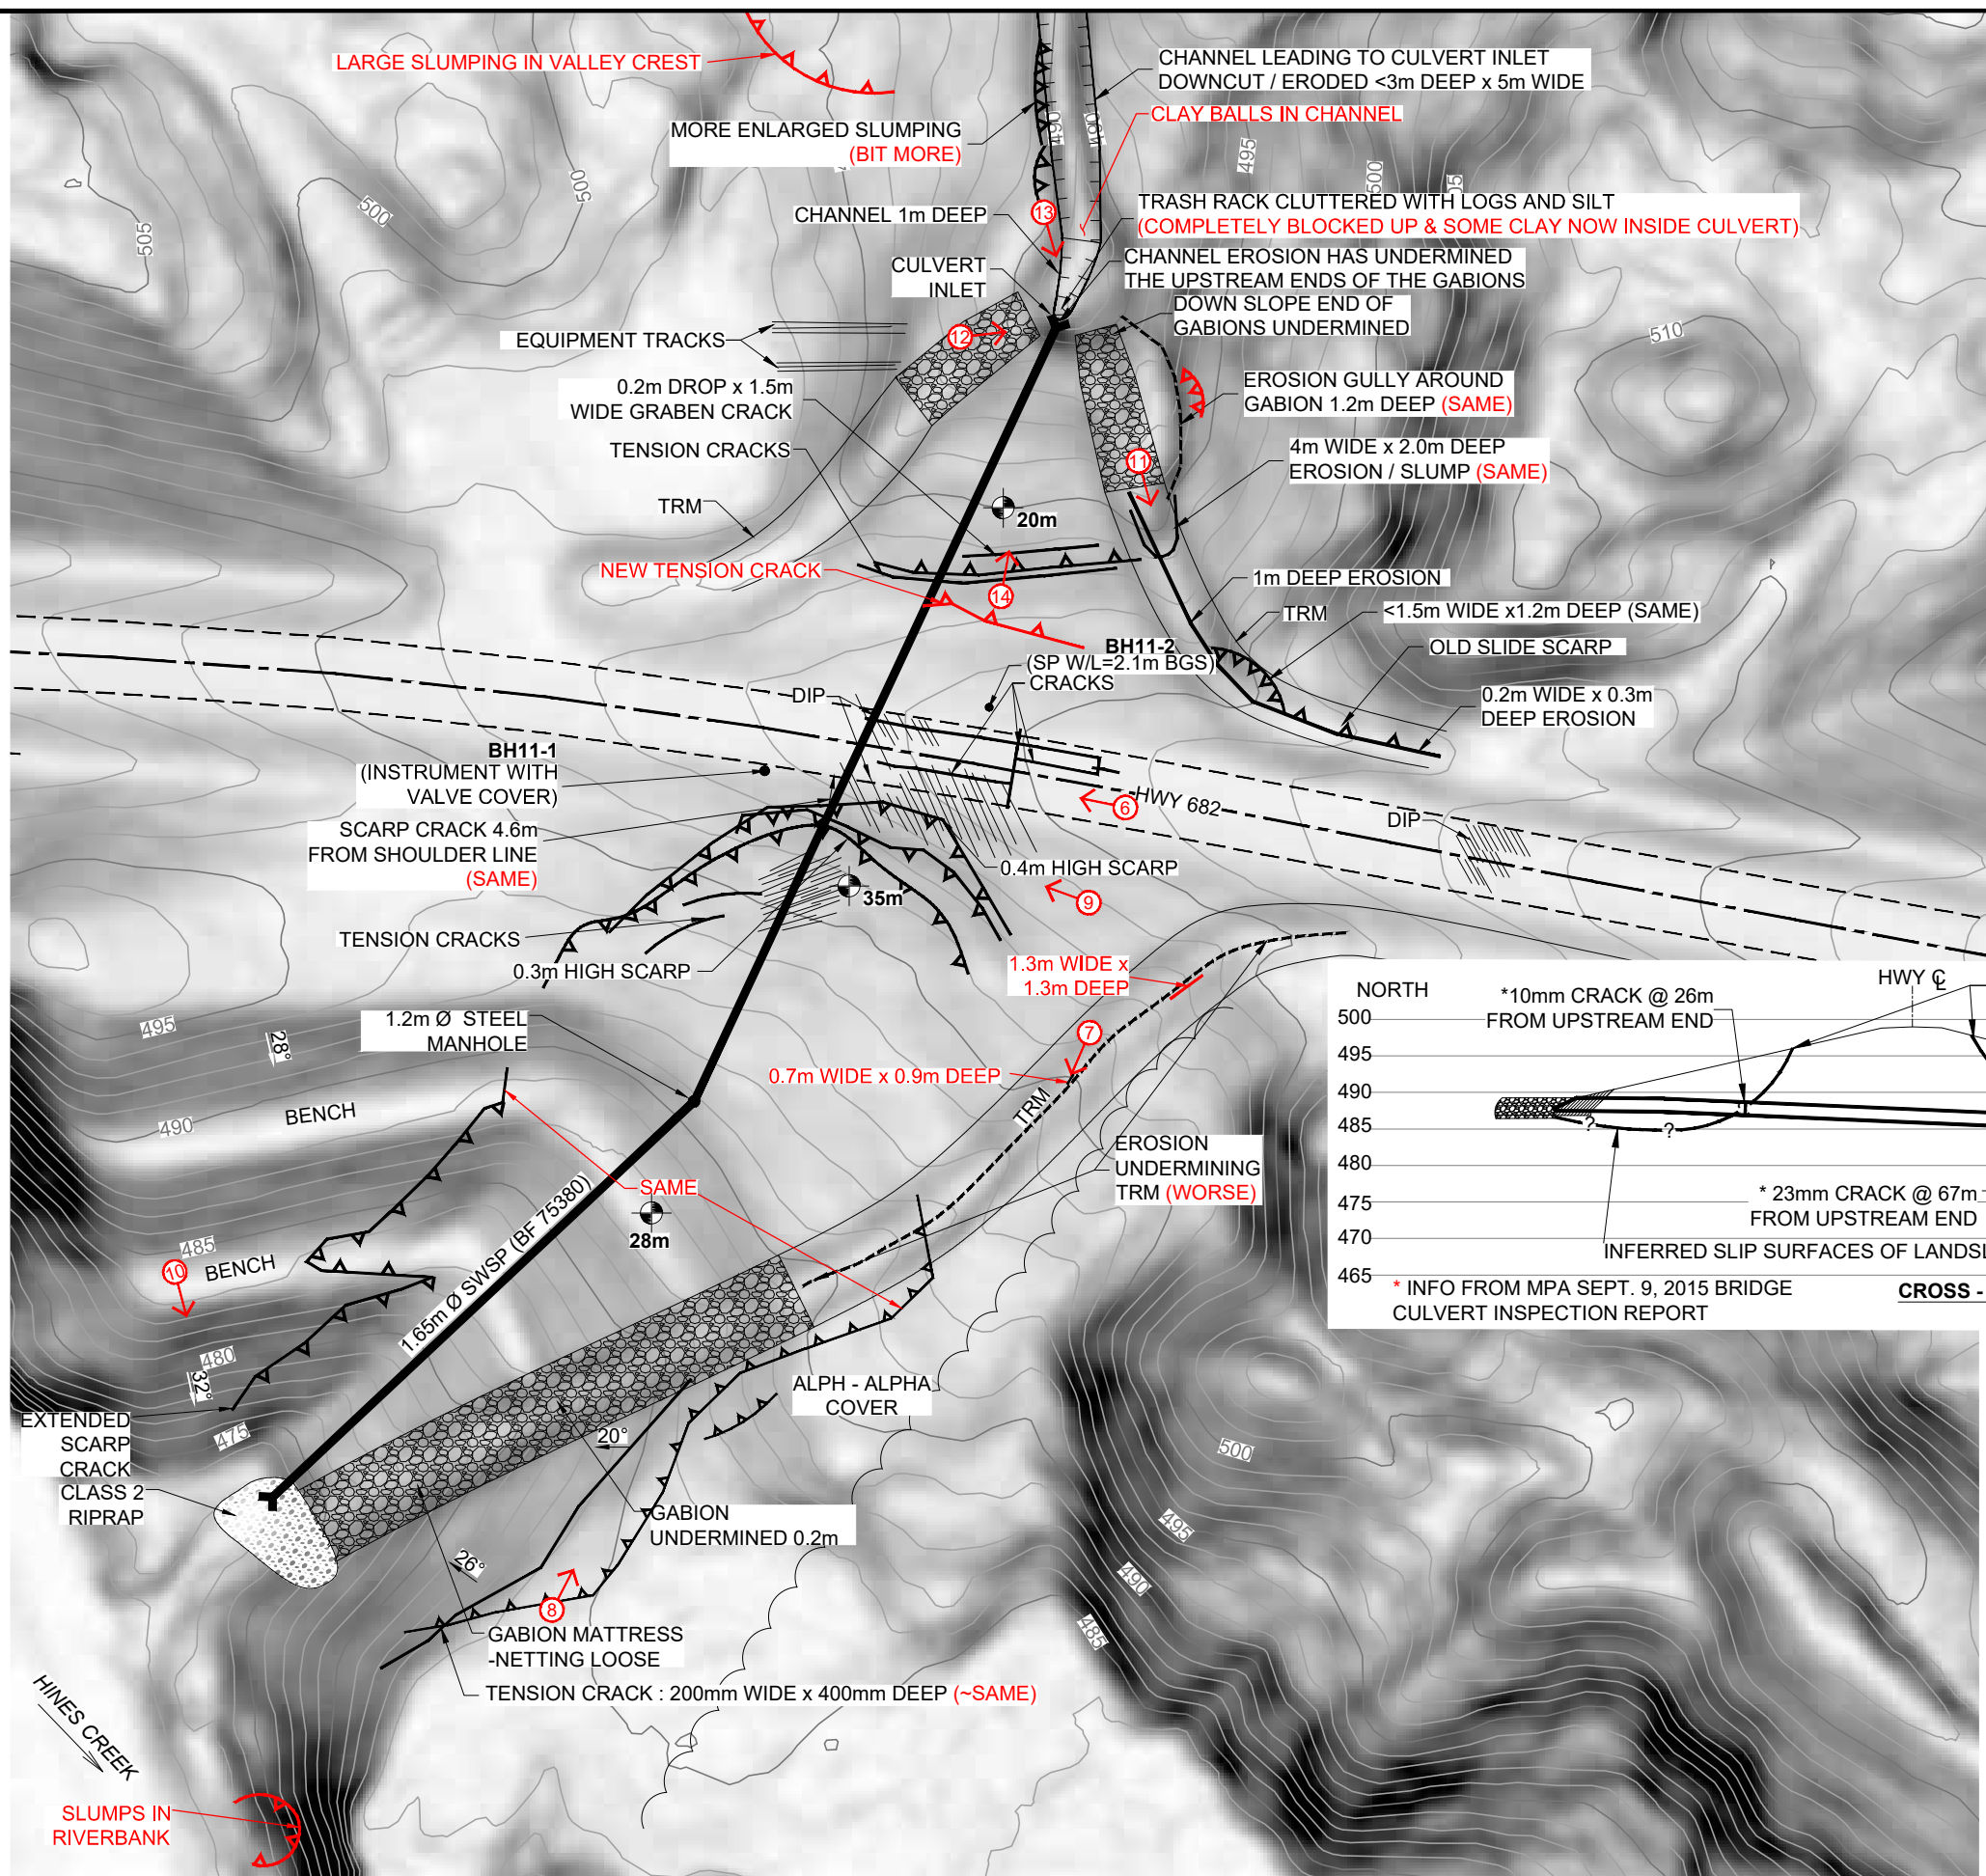


LEGEND

- SLIDE SCARP
- APPROXIMATE TREE LINE
- APPROXIMATE GUARD RAIL LOCATIONS
- PHOTOGRAPH NUMBER, AND APPROXIMATE DIRECTION AND LOCATION
- GABION MATTRESS
- SETTLEMENT AREAS
- PROPOSED SI / PIEZOMETER LOCATION
- 25m** DEPTH OF THE TEST HOLE IN METRES

NOTES

1. GABIONS LACKING INTERMEDIATE BAFFLES AND LIDS NOT ADEQUATELY TIED.
2. MAY 13, 2019 OBSERVATIONS SHOWN IN RED.

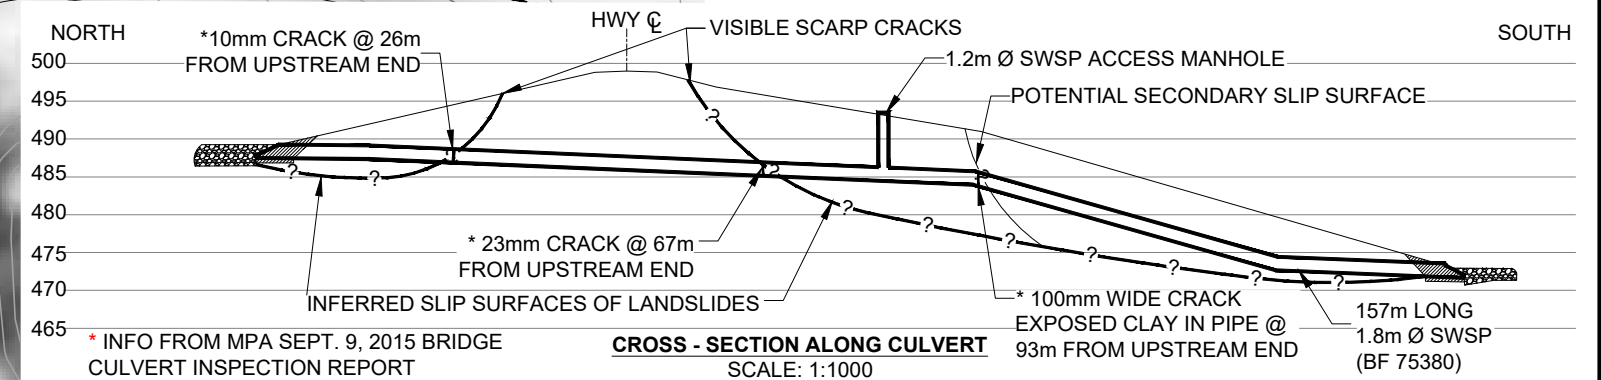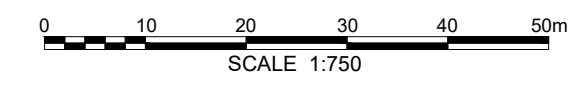

BASE LIDAR FLOWN IN 2015



PEACE REGION (PEACE RIVER/HIGH LEVEL)

PH077-2: EAST SIDE OF HINES CREEK BRIDGE
 HWY 682:02, km 12.6~12.7
 2019 INSPECTION PLAN - SITE 2

DWG No. 13351-PH077-2-1

DRAWN BY	ML
DESIGNED BY	BDM
APPROVED BY	DWP
SCALE	1:750
DATE	MAY 13, 2019
FILE No.	13351

