



PLAN
SCALE 1:1000 (APPROX.)

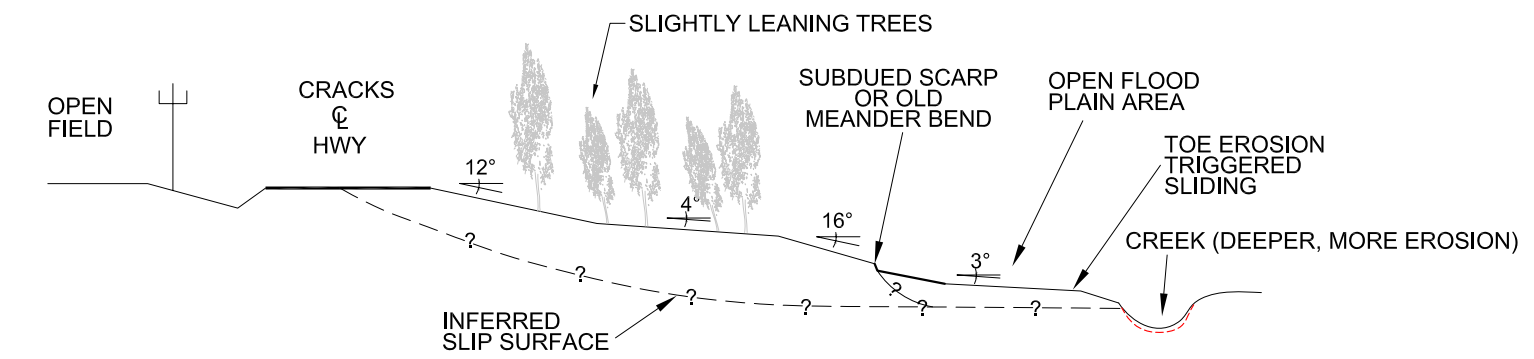

SECTION A - A'
SCALE 1:500 (APPROX.)

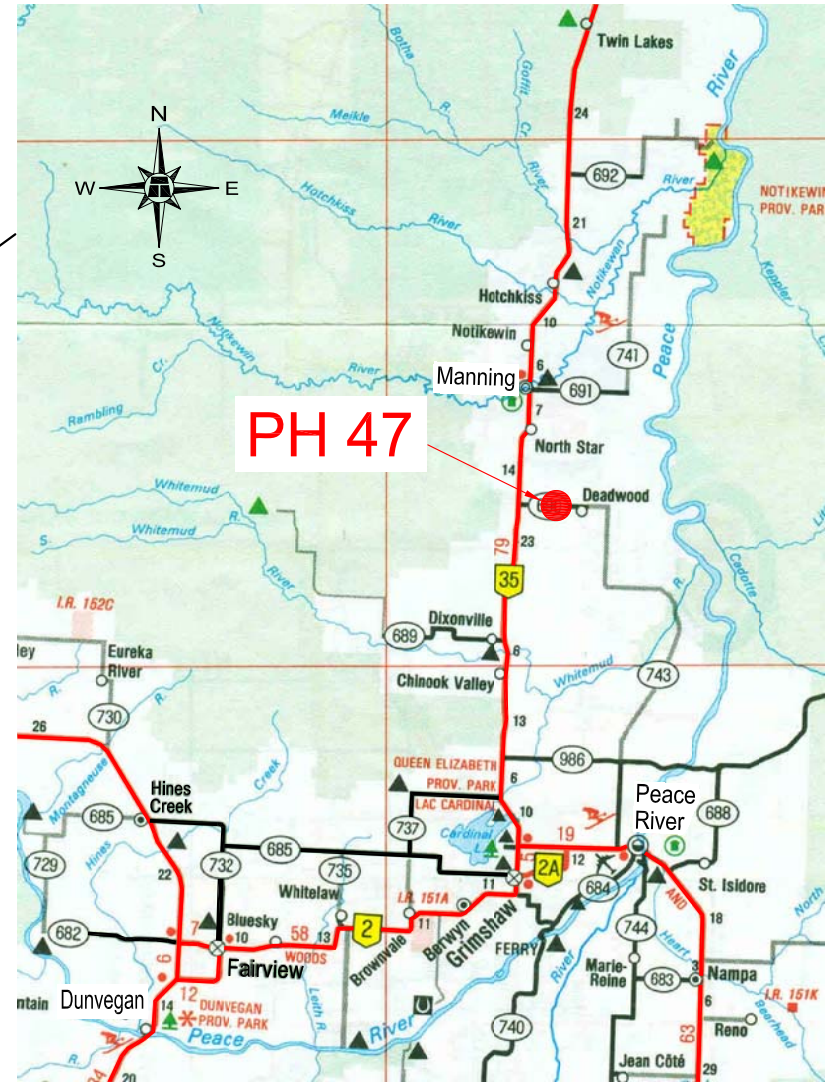

- NOTES :**
1. FEATURE LOCATIONS ARE APPROXIMATE.
 2. PREVIOUS OBSERVATIONS SHOWN IN BLACK
 3. MAY 2007 OBSERVATIONS SHOWN IN RED

- LEGEND :**
- T TELUS PEDESTAL
 - PROPOSED SI AND PZ LOCATION
 - ⊕ PROPOSED PZ LOCATION
 - ① → PHOTO AND DIRECTION

FIGURE PH47-1
DEADWOOD SLIDE- PH47 - HWY 690:02
PEACE REGION (PEACE RIVER/HIGH LEVEL)
GEOHAZARD ASSESSMENTS
DATE : MAY 2007
THURBER PROJECT # 15-85-72