
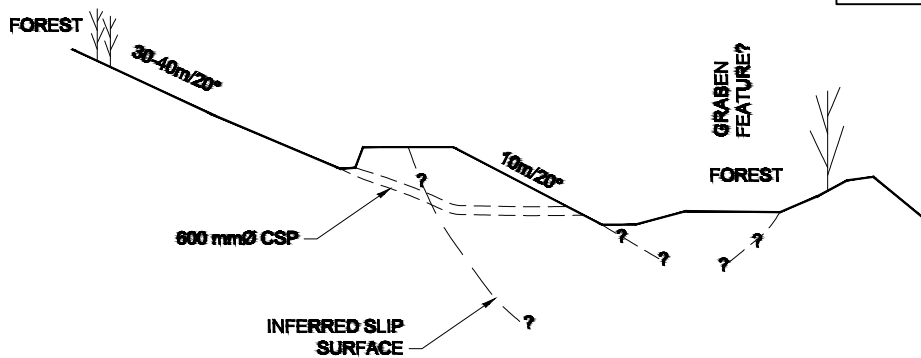


NOTE:
 PATCHED IN 2005, AND ALL
 CRACKS ABOUT THE SAME
 AS OBSERVED IN 2004

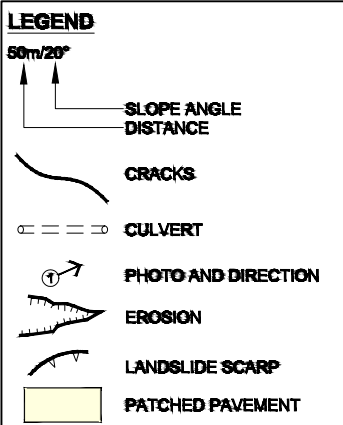

CROSS SECTION A - A'

NOTES

1. ACP OVERLAY PLACED SUMMER 2001
2. FEATURE LOCATIONS ARE APPROXIMATE.
3. PREVIOUS OBSERVATIONS SHOWN IN BLACK
4. JUNE 18, 2013 OBSERVATIONS SHOWN IN RED.

NOT TO SCALE

REFERENCE: BASE "SITE PLAN", SH12s907plan.pdf, SUPPLIED BY ALBERTA INFRASTRUCTURE AND TRANSPORTATION.

CLIENT: 	DWN BY: CMG/PK	PROJECT: GEO HAZARD ASSESSMENT PEACE REGION (SWAN HILLS)	DATE: DECEMBER, 2013
	CHK'D BY: EP		PROJECT No.: EG10030
 AMEC Environment & Infrastructure 5681-70 STREET, EDMONTON, ALBERTA, T6B 3P6 PHONE 780-436-2152, FAX 780-435-8425	DATUM: -	TITLE: SH12-9 HWY 744:02 LITTLE SMOKY RIVER VALLEY SITE PLAN AND CROSS SECTION	REV. No.: A
	PROJECTION: -		FIGURE No.: FIGURE 2
	SCALE: NOT TO SCALE		