


SCALE 1:1000 (APPROX.)

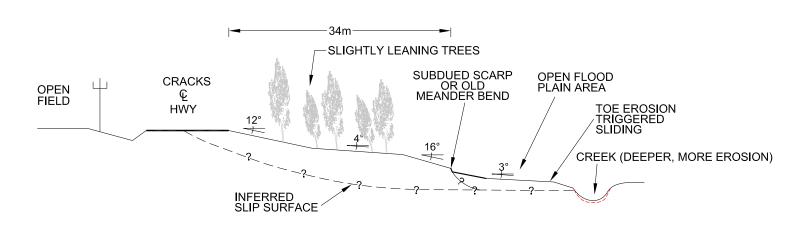

## SECTION A - A' SCALE 1:500 (APPROX.)

## **NOTES:**

- 1. FEATURE LOCATIONS ARE APPROXIMATE
- 2. PREVIOUS OBSERVATIONS SHOWN IN BLACK
- 3. JUNE 2011 OBSERVATIONS SHOWN IN RED

## **LEGEND:**

- TELUS PEDESTAL
- PROPOSED PZ LOCATION
- 1 PHOTO AND DIRECTION

FIGURE PH47-1
DEADWOOD SLIDE- PH47 - HWY 690:02
PEACE REGION (PEACE RIVER/HIGH LEVEL)
GEOHAZARD ASSESSMENTS

DATE : JUNE 2011

